

	00//50 / 51	Sewer Pip	INV LEVEL				MAX	MIN		YEAR
REFERENCE SK08339902	85.68	UPSTR 84.36	BOWNSTR 84.05	FURP	MATL	SHAPE	SIZE	SIZE	GRADIENT	LAID
SK08339902	87.68	84.36	84.05	F S	vc co	c c	225 675	nil	49.13 84.47	nill
SK08339911	87.64	85.61	nil	F	VC	c	300	nil	0.00	nill
SK08339912	87.66	86.98	86.49	F	VC	С	225	nil	100.82	nill
SK08339918	87.25	85.63	nil	F	VC	с	100	nil	0.00	nill
SK08339919	87.32	85.77	85.69	F	VC	С	100	nil	37.13	nill
SK08339921 SK08339922	87.20 86.85	84.09		S	co	c	675	nil	0.00	nill
SK08339923	85.80	83.43	84.07 nil	F S	vc co	c c	300 600	nil	49.13	nill
SK08339924	86.55	83.86	83.44	s	co	c	450	nil	0.00	nill
SK08349003	86.62	85.05	84.85	F	vc	с	225	nil	115.35	nill
SK08349015	89.37	87.74	87.58	s	vc	с	225	nil	160.63	2005
SK08349016	89.33	87.58	87.04	s	vc	с	225	nil	40.44	2005
SK08349017 SK08349018	88.90 87.70	87.04	86.20	S	VC	C	225	nil	22.07	2005
SK08349019	86.95	86.20	85.32 84.09	s s	vc vc	c c	225	nil	15.58	2005
SK0834902D	89.31	87.46	87.15	F	VC	c	225 150	nil	19.20 77.23	2005 2005
SK08349021	89.28	87.15	86.68	F	vc	с	150	nil	35.98	2005
SK08349022	88.97	86.68	86.01	F	vc	С	150	nit	19.06	2005
SK08349023	88.21	86.01	85.33	F	vc	С	150	nil	31.65	2005
SK08349024	86.92	85.30	84.79	F	vc	С	150	nil	34.20	2005
SK08349025 SK08349101	86.15 89.32	84.85	84.40	F	VC	C	225	nil	49.78	nill
SK08349102	89.30	87.07 87.08	nil 84.65	s	vc vc	c c	150 300	nil	0.00	nill
SK08349104	90.57	87.95	nil	F	VC	c	150	nil	30.19 0.40	nill
SK08349106	90.53	88.36	nil	s	VC	c	200	nil	0.40	nill
SK08349204	87.93	86.67	86.16	s	vc	с	150	nil	73.25	nill
SK08349302	87.70	86.05	85.05	s	VC	с	225	nil	52.15	nill
SK09330801	89.61	87.97	87.78	F	со	С	460	500	28.37	nill
SK09330802	89.32	86.68	nil	S	VC	c	375	nil	0.00	nill
SK09330804 SK09330805	89.34 nil	87.31 nil	85.68	F	VC	C C	225	nil	38.54	nill
K09330805 K09330901	nii 85.46	nii 83.97	83.94 83.89	S F	vc co	c c	375 400	nil	0.00	nill
K09330902	85.42	83.85	83.53	F	co	c	400	nil	55.88 70.50	nill
K09330903	85.55	83.51	83.43	F	со	С	400	nil	141.38	nill
K09330904	85.51	83.52	83.14	F	vc	с	225	nil	94.34	nill
K09330907	84.92	81.95	81.60	S	СІ	с	900	nil	158.97	nill
K09330908	85.55	83.15	83.13	F	VC	с	225	nil	1414.00	nill
K09330910	85.68	83.93	82.32	S	со	с	450	nil	14.76	nill
K09330911 K09330921	nil 85.42		nil	F	nil	nil	nil	nil	0.00	nill
1	87.06	83.42 86.47	83.14 86.11	F	co vc	c c	400	nil	81.71	nill
K09331904	87.01	86.59	nil	F	vc	c	150	nil	20.03	nill
K09331907	87.22	86.93	86.72	F	vc	с	100	nil	25.67	nill
K09331910	86.20	nil	nil	F	nií	nil	nil	nit	0.00	nill
K09331911	86.46	nil	nil	F	nil	nil	nil	nil	0.00	nill
	86.01		nil	F	nil	nil	nil	nil	0.00	nill
	nil		nil	F	vc	с	150	nil	0.00	nill
α	nil		nil	F	VC	C	150	nil	0.00	nill
87	nil		nil nil	s	vc vc	с с	150 150	nil	0.00	nill
Č.	nil		nil	F	vc	c	150	nil	0.00	nill nill
K09331918	86.79		83.88	s	vc	nil	225	nil	34.45	nill
K09332801	nil	nil	nil	F	nil	nil	nil	nil	0.00	nill
< •'	nil	nil	nil	F	nil	nil	nil	nil	0.00	nill
¢.	nil		nil	F	nil	nil	nil	nil	0.00	nill
τ.	85.92 86.55		nil	F	VC	C	100	nîl	0.00	nill
N	86.22			F	VC nil	nil	150 cil	nil	0.00	nill
	86.19			F	nil	nil	nil	nil	0.00	nill nill
K09332908	86.14			F	nil	nil	nil	nil		nill
<09340001	84.69	83.13	82.62	F	со	С	400	nil		nill
	84.44			F	VC	с	225	nil	0.00	nill
	84.25			S	со	С	975	nil	160.54	กเป
	84.42 84.83			F	CO	<u>с</u>	375	nil	0.00	nill
	84.83 84.83			F F	co vc	с с	400 225	nil		nill
	84.85			F	VC	c	225	ni		nill nill
	85.32			F	VC	c	150	nil		nill
(09340011 8	84.74	82.82	82.58	F	vc	с	150	nil		nill
	85.50			F	vc	С	150	nil	0.00	nill
	85.64			F	VC	с	150	nil		nill
	35.51 35.80			FF	VC	C	150	nil		nill
	36.93				VC VC	с с	150 150	nil		nill
	37.11			F		c c		nil		nill
	****					c		nil		nill
٤09340019 ٤	35.61	84.87 8	33.03					nil		nill
					nil	nil	nil	nil		nill
								nil	0.00	nill
								nil		nill
								nil		2007
								nil nil		nill
						c c		nil		nill
								nil		nill
(09340112 r	nil	nil 8	34.62					nil		nill
					VC	с	225	nil		nill
								nil		nill
								nil		nill
								nil		nill
								nil nil		nill nill
09340208 8		UTILU IL	0.01		00		3/0 1	nil	131.31	nill

Sewer Chemical Injection Point	ΜΑΤ	ERIAL
Sewer Junction	AC	- ASBESTOS (
	BR	- BRICK
Sewerage Air Valve		
	CC	- CONCRETE
Sewerage Hatch Box Point	CI	- CAST IRON
a b b b b b b b b b b	CO	- CONCRETE
Sewerage Isolation Valve	CSB	- CONCRETE
Soakowov	CSU	- CONCRETE
Soakaway	DI	- DUCTILE IRC
Surface Water Manhole	GRC	- GLASS REIN
	MAC	- MASONRY IN
Vent Column	MAR	- MASONRY R
	PE	- POLYETHLE
	PF	- PITCH
Waste Water Storage	PP	- POLYPROPY
	PSC	- PLASTIC STE
Culverted Watercourse	PVC	- POLYVINYL (
	RPM	- REINFORCE
Pre-1937 Properties	SI	- SPUN (GREY

	117		
AT	ERIALS	С	ATEGOR
	- ASBESTOS CEMENT	W	- WEIR
	- BRICK	С	- CASCADE
	4 12		
	- CONCRETE BOX CULVERT	DB	- DAMBOARD
	- CAST IRON	SE	- SIDE ENTRY
	- CONCRETE	FV	- FLAP VALVE
В	- CONCRETE SEGMENTS (BOLTED)	BD	- BACK DROP
U	- CONCRETE SEGMENTS (UNBOLTED)	S	- SIPHON
	- DUCTILE IRON	HD	- HIGHWAY DRAIN
С	- GLASS REINFORCED CONCRETE	S104	- SECTION 104
С	- MASONRY IN REGULAR COURSES	SHA	PE
R	- MASONRY RANDOMLY COURSED	С	- CIRCULAR
	- POLYETHLENE	E	- EGG SHAPED
	- PITCH	0	- OTHER
	- POLYPROPYLENE	R	- RECTANGLE
0	- PLASTIC STEEL COMPOSITE	S	- SQUARE
0	- POLYVINYL CHLORIDE	т	- TRAPEZOIDAL
М	- REINFORCED PLASTIC MATRIX	υ	- UNKNOWN
	- SPUN (GREY) IRON		
<	- OTHER		
Privat	e Sewers are shown in magenta		

CATEGORIES W - WEIR

TABULAR KEY

- A. Sewer pipe data refers to downstream sewer pipe.
- B. Where the node bifurcates (splits) X and Y indicates downstream sewer pipe.
- C. Gradient is stated a 1 in...

PURPOSE


- C COMBINED E - FINAL EFFLUENT
- F FOUL
- L SLUDGE S - SURFACE WATER



All section 104 sewers are shown in green All Sewers that have been transferred to Severn Trent Water after the 1st October 2011, but have not been surveyed and confirmed by Severn Trent Water are shown in orange

	Sewer Pipe Data								
COVER LEVEL	INV LEVEL UPSTR	INV LEVEL DOWNSTR	PURP	MATL	SHAPE	MAX SIZE	MIN SIZE	GRADIENT	YEAR LAID
86.19	84.69	84.29	s	со	С	375	nil	150.08	nill
nil	nil	nil	F	nil	nil	nil	nil	0.00	nill
nil	nil	81.23	F	nil	nil	nil	nil	0.00	nill
36.32	nil	nil	F	nil	nil	nil	nil	0.00	nill
nil	nil	nil	F	nil	nil	nil	nil	0.00	nill
35.26	nil	83.20	F	nil	nil	nil	nil	0.00	nill
35.85	84.00	83.88	s	vc	nit	225	nil	170.00	nill
36.26	83.88	83.50	S	VC	nil	225	nil	30,76	nill
35.42	83.50	82.34	s	VC	nil	225	nil	17.90	2007
34.38	82.34	82.28	s	со	nil	900	nil	251.06	2007
3.88	82.28	82.20	S	со	nil	900	nil	249.03	2007
4.03	82.33	82.28	s	со	nil	900	nil	249.15	2007
3.71	82.20	82.16	S	со	nil	900	nil	249.30	2007
3.66	82.11	82.08	S	vc	nil	225	nil	171.43	2007
3.64	81.19	80.70	S	со	с	975	nil	160.29	nill
6.02	82.57	nil	S	vc	с	375	nil	0.00	nill
4.26	81.20	81.17	F	СІ	с	450	nil	275.00	nill
nil	nil	nil	s	nil	nil	nil	nil	0.00	nill
nil	nil	nil	S	nil	nil	nil	nil	0.00	nill
ni	nil	81.31	s	nil	nil	níl	nil	0.00	nill
5.87	85.39	85.21	F	vc	С	100	nil	74.56	nill
5.91	nil	85.40	F	nil	nil	nil	nil	0.00	nill
5.90	nil	nil	F	nil	nil	nil	nil	0.00	nill

Sewer Nod

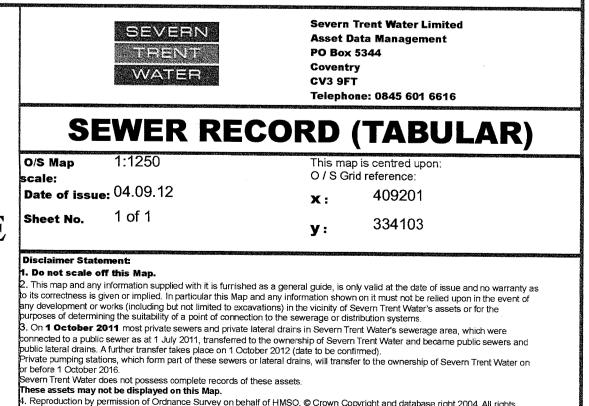

4. Reproduction by permission of Ordnance Survey on behalf of HMSO. © Crown Copyright and database right 2004. All rights reserved. Ordnance Survey licence number 100018202. Document users other than Severn Trent Water business users are advised that this document is provided for reference purpose only and is subject to copyright, therefore, no further copies should be made from it.